

**Amendments to the Drawings:**

The drawing sheet or sheets attached in connection with the above-identified application containing FIGS. 2 and 4 are being presented as a new formal drawing sheet or sheets to be substituted for the previously submitted drawing sheet or sheets. The drawing FIGS. 3 and 4 have been amended to correct a numbering error and a line position improperly drawn. Appended to this amendment is an annotated copy of the previous drawing sheet which has been marked in red ink to show changes presented in the replacement sheet of the drawing.

The specific changes which have been made to FIGS. 3 and 4 are that the number 224 is repeated and thus has been change to --225-- in these figures. In addition, the returned light beam 220 has been properly repositioned since it must intersect ocular lens 222; otherwise the light beam 220 could not possibly be bent by the ocular lens 222 as shown.

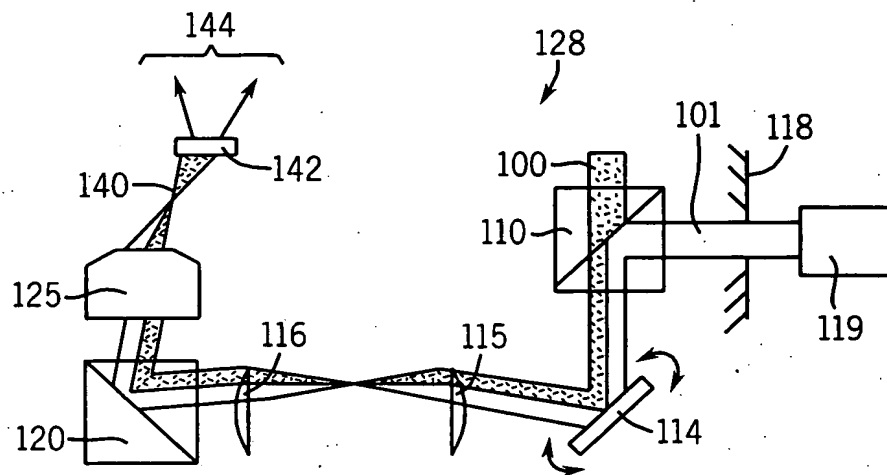


FIG. 1  
PRIOR ART

RECEIVED  
NOV 19 2004  
TECH CENTER 2800

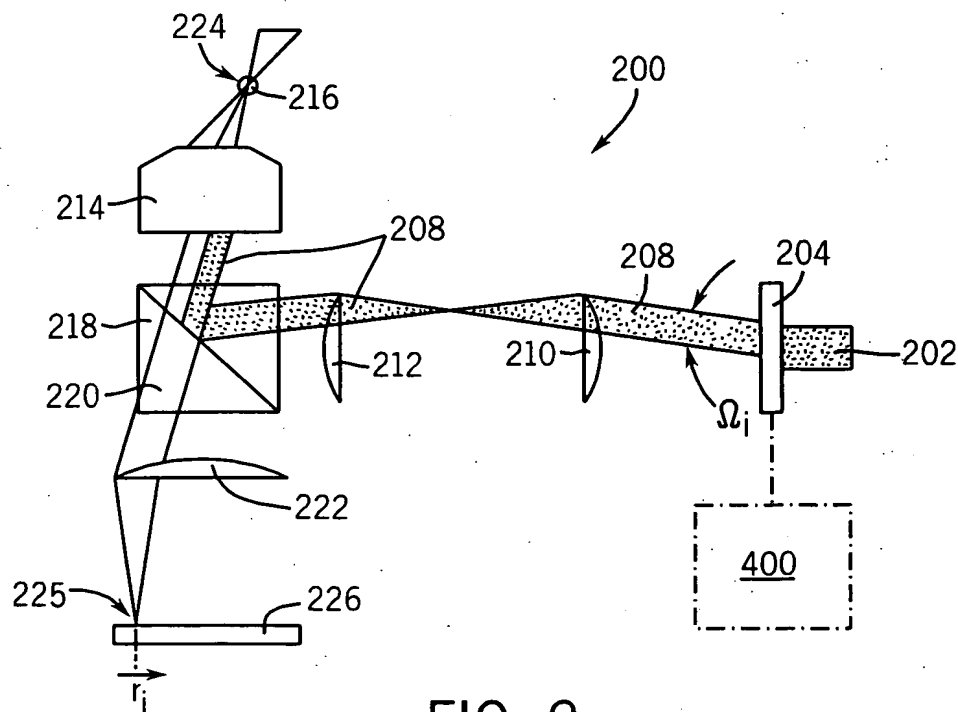


FIG. 2



TITLE: PARALLEL SCANNED LASER CONFOCAL MICROSCOPE

INVENTOR(S): GRIER ET AL.

APPL. NO.: 09 / 917,346

REPLACEMENT SHEET

2 / 2

